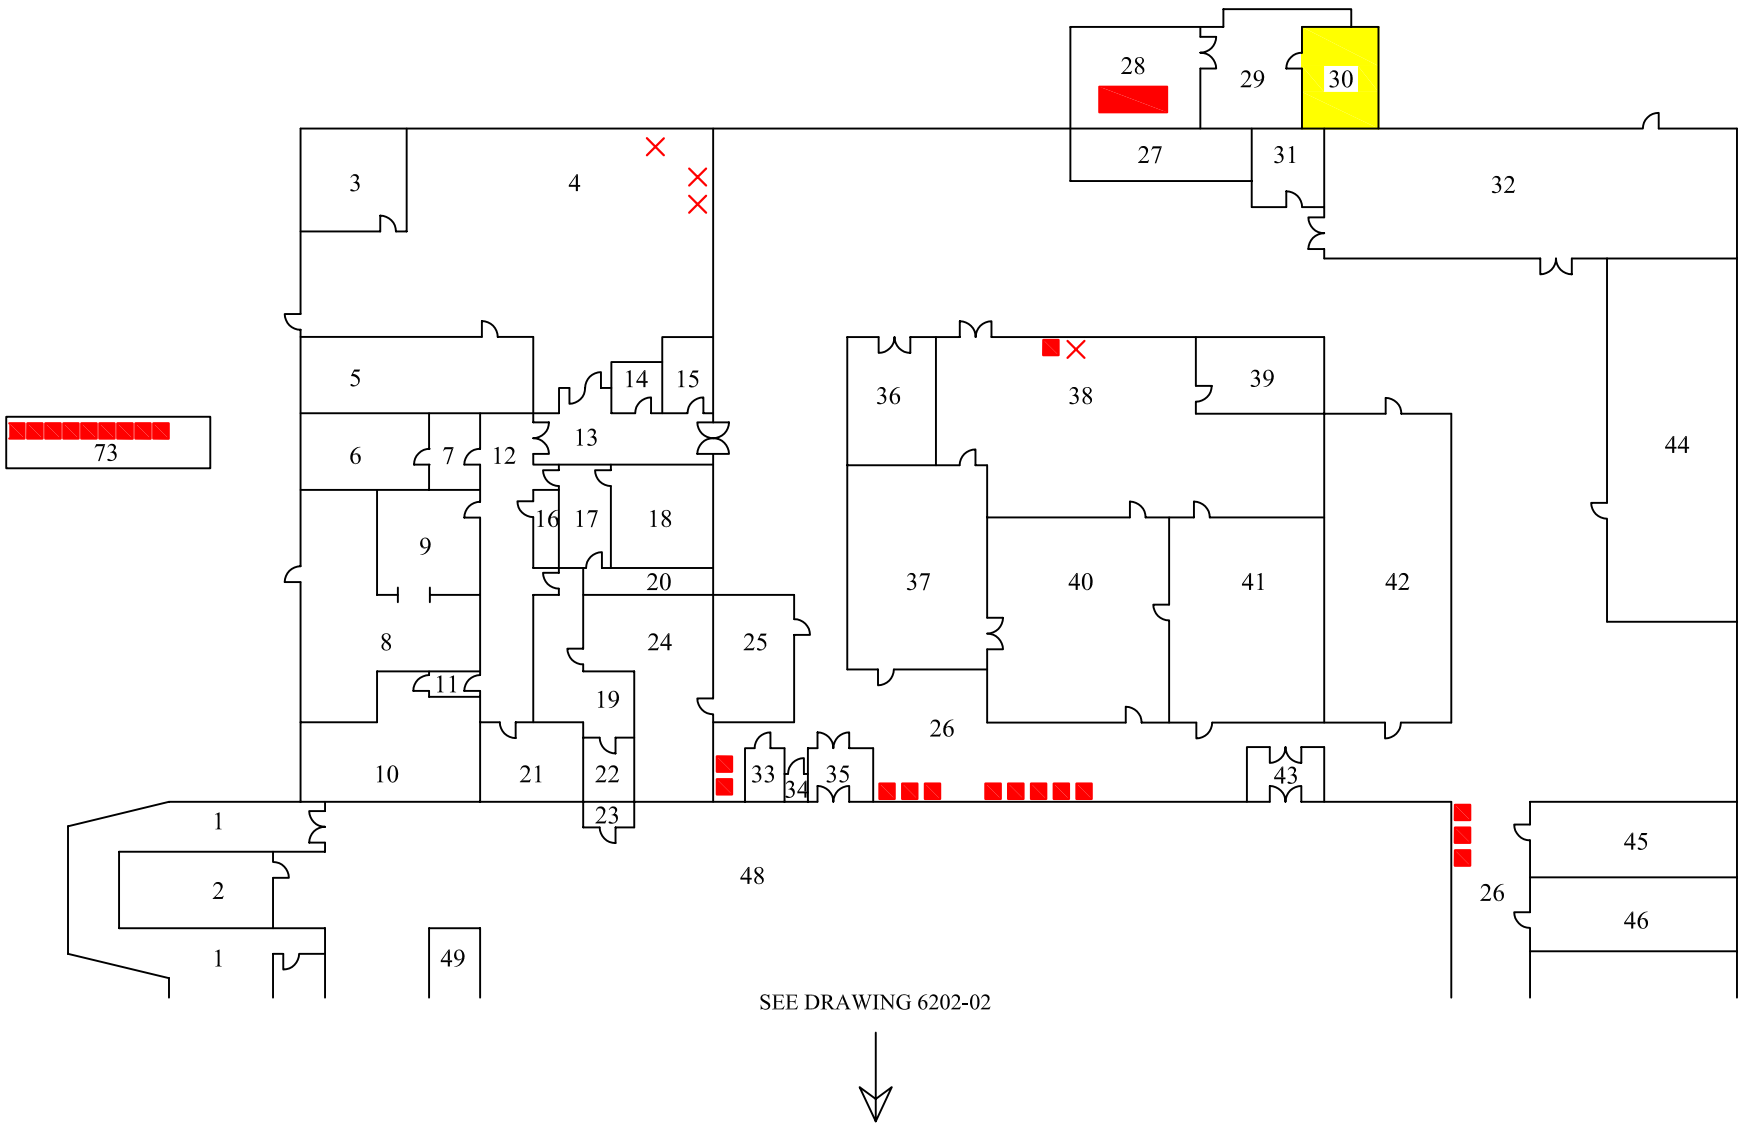

SEE DRAWING 6202-02

REVISIONS	DATE	DRAWN
FIRST ISSUE OF DRAWING	06/12/02	CBSL

DRAWING NOT TO SCALE

KEY

Yellow	- No Access
Red	- Asbestos Products
No Shading	- Clear

- ELECTRICAL RISER COVER
- ELECTRIC PANEL
- ELECTRIC BOX
- BRAKE SHOES
- ACCESS DOOR
- EXHAUST
- BITUMIN PADS
- GASKETS
- SINK PADS

REMOVED NON-ASBESTOS MATERIALS MARKED IN BLACK
ASBESTOS MATERIALS MARKED IN RED

CLIENT & JOB TITLE
Major Supermarket Chain
Windermere Drive
Blackpole, Worcester

DRAWING TITLE
Ground Floor Level

DRAWING NUMBER
6202-01

DRAWN BY CAD Bureau Southern Ltd

Not to scale. Approximate dimensions shown for identification purposes only. This site sketch is intended for the location of areas only in relation to the asbestos survey.

Customer Name & Logo